




EXISTING THIRD FLOOR PLAN
SCALE 1:100

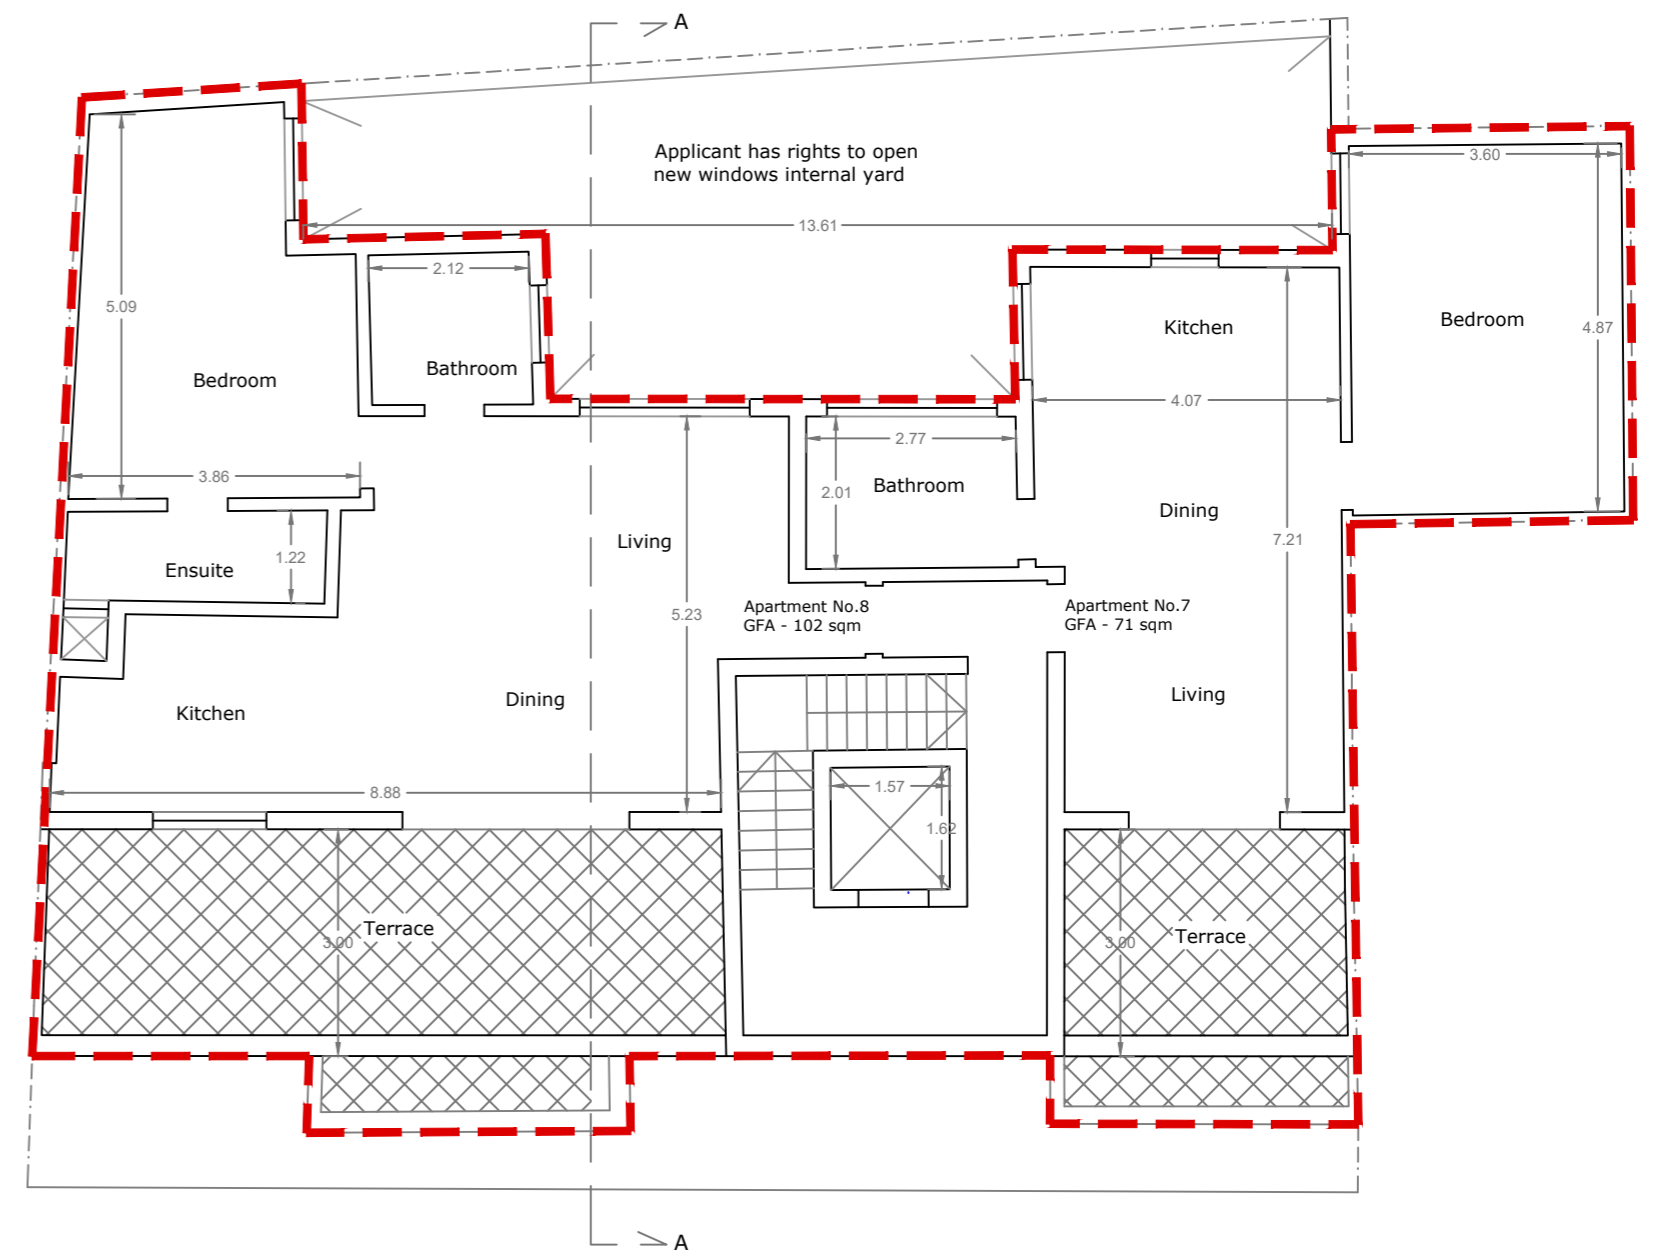

PROPOSED RECEDED FLOOR PLAN
SCALE 1:100

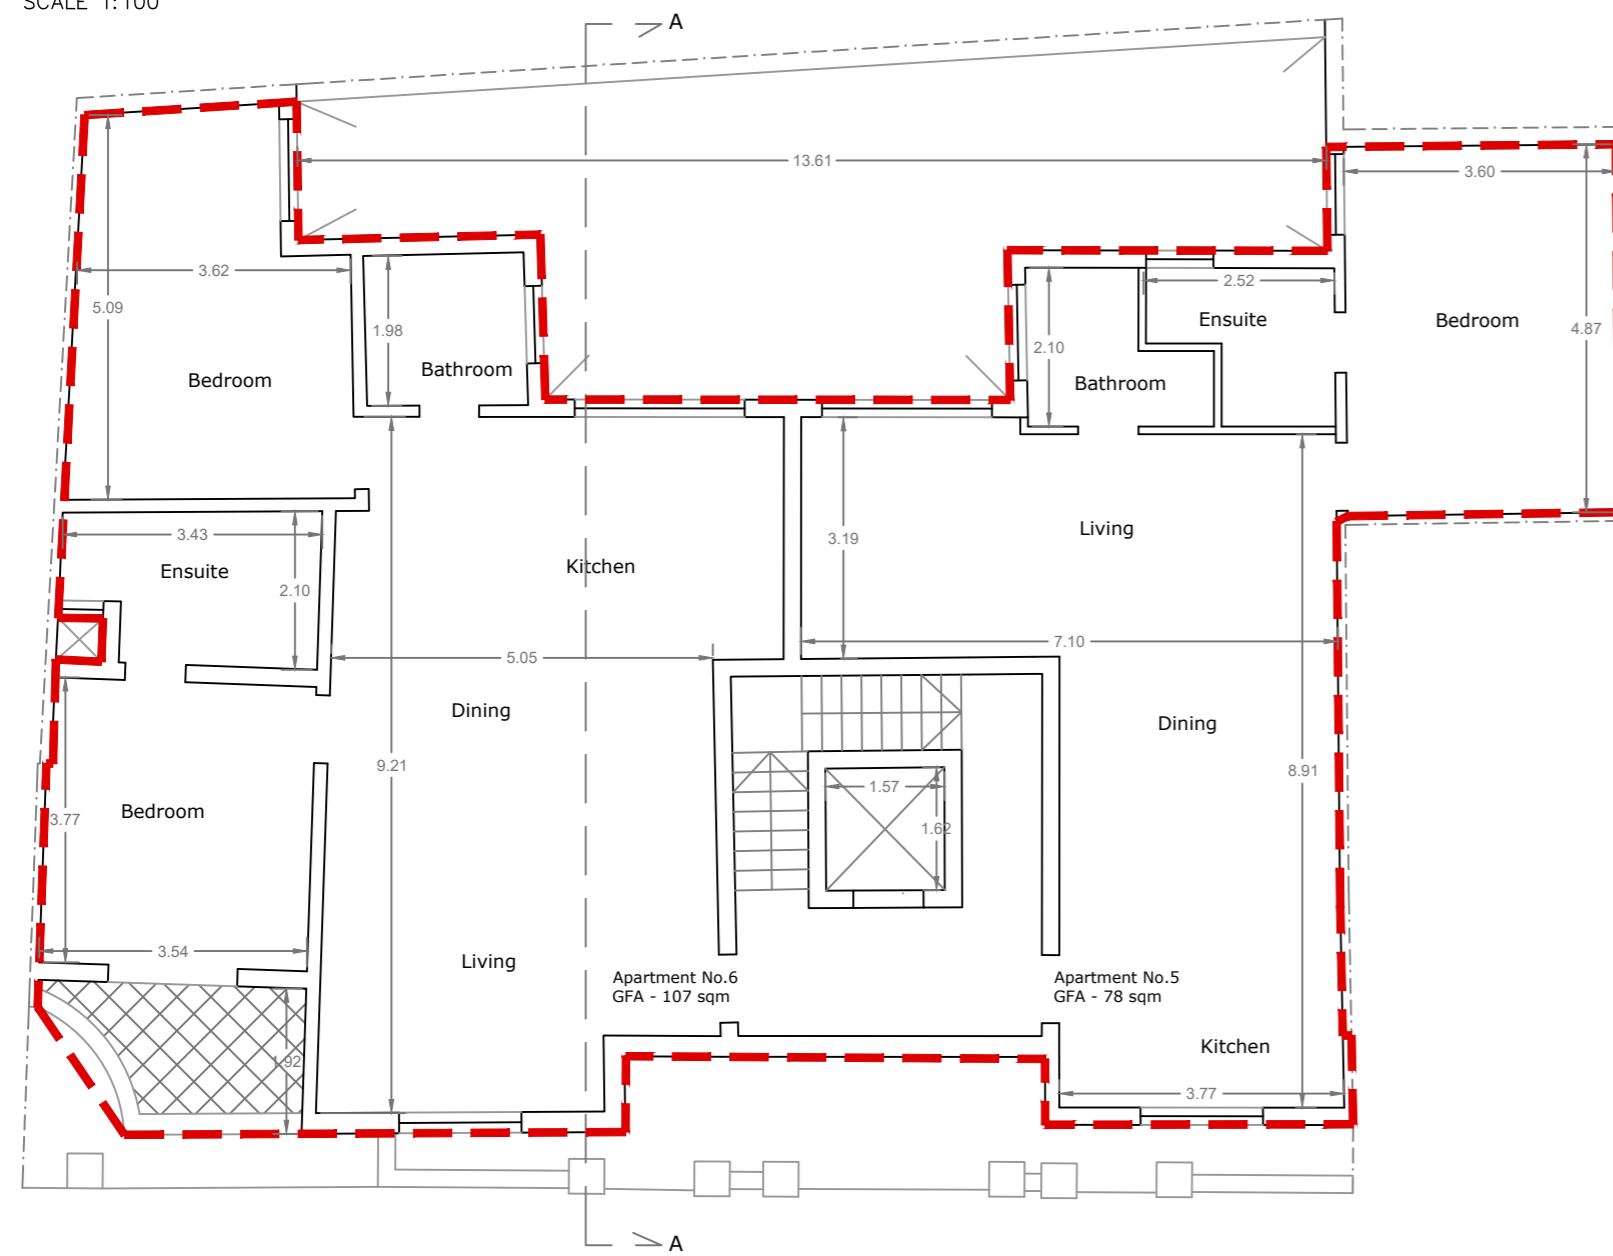

PROPOSED THIRD FLOOR PLAN
SCALE 1:100

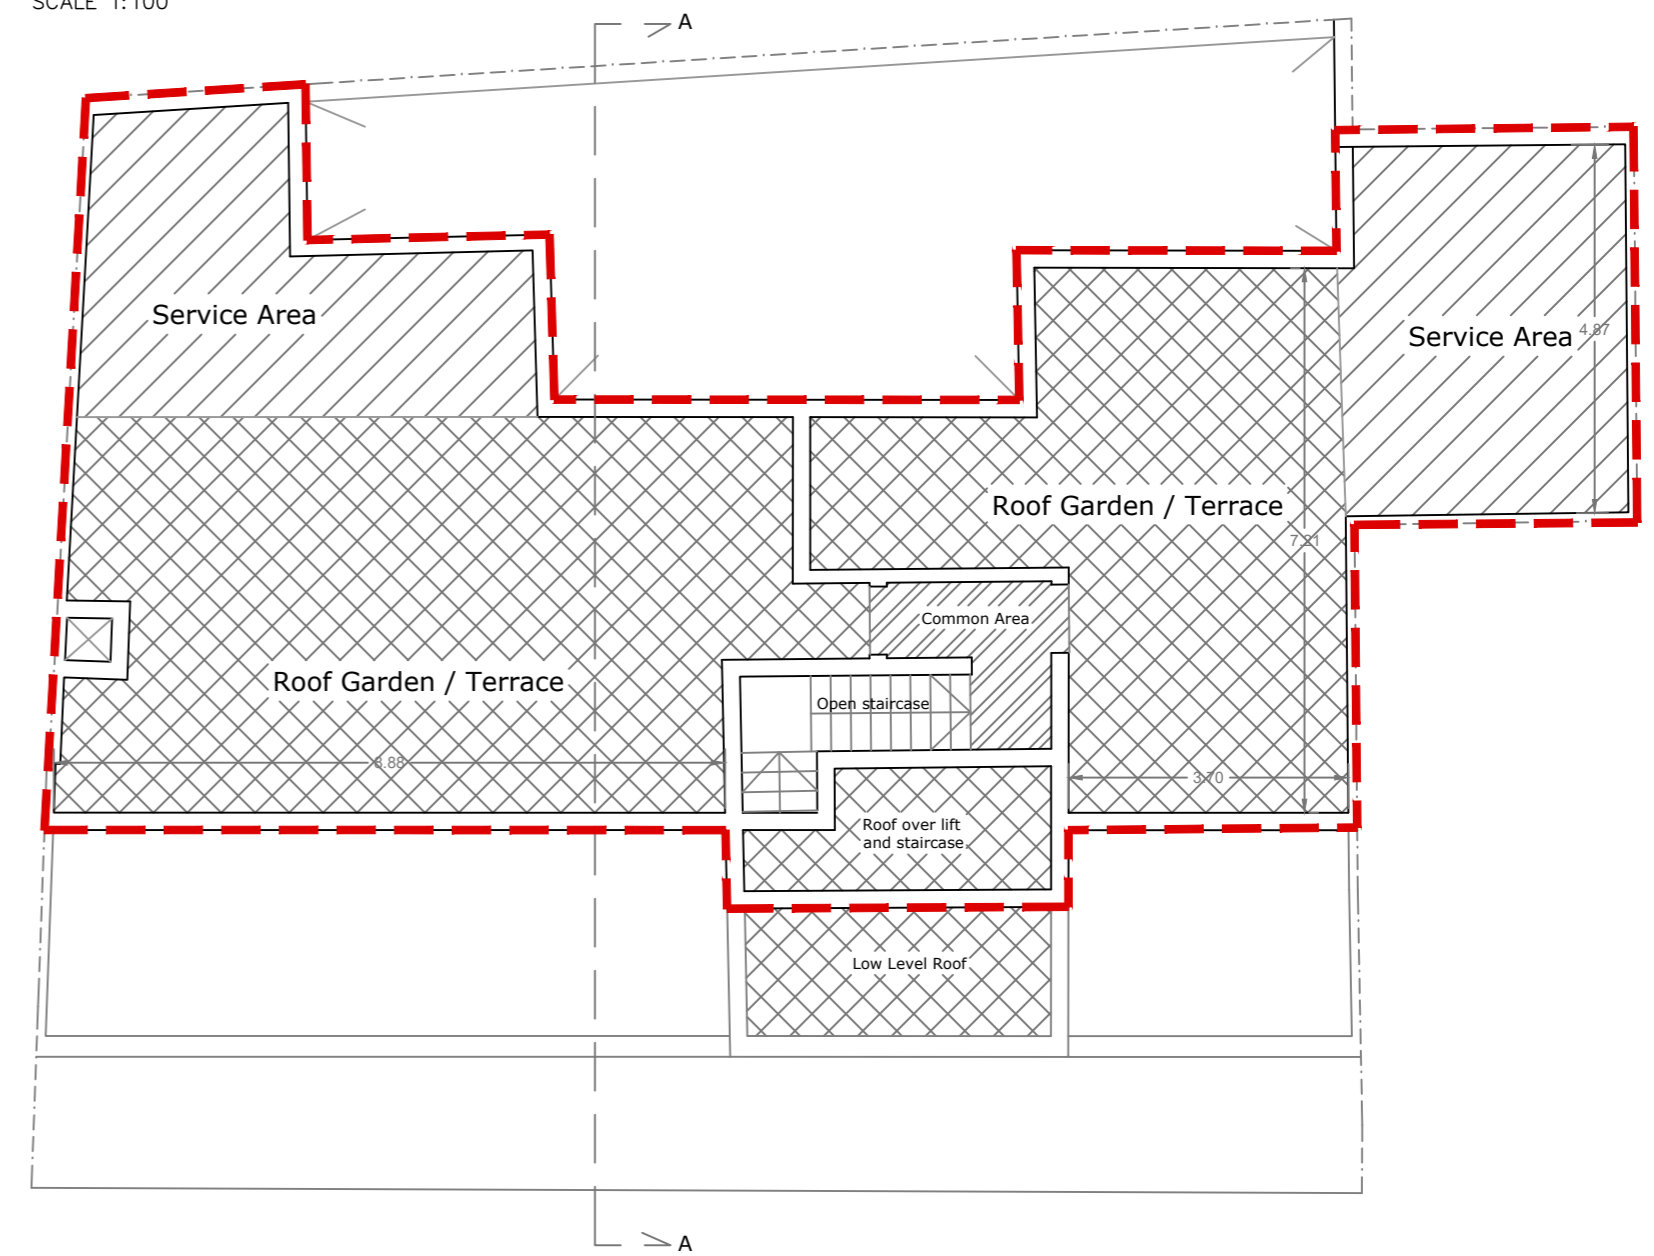

PROPOSED ROOF PLAN
SCALE 1:100



- EXISTING - TO BE DEMOLISHED
- PROPOSED - TO BE CONSTRUCTED
- APPROVED BUT NOT BUILT
- TO SANCTION - AS BUILT

Project ROSAMARIS COURT, FLATS 5-8 TRIO L-ISKALL, MARSASCALA.	Drawing Name EXISTING & PROPOSED FLOOR PLANS	Drawn: MB Date: 07-08-23 Approved: MB Scale: 1:100 (A2) File No: 102	Matthew Bugeja A & CE <small>172, St. Angelo's Zebbar Road, Paola FLA 1013 M: 7900 2495 E: matthew.bugeja@gmx.com</small>	
	Drawing No: 001 Rev: A			